



**AS BUILT**  
 ESCALA: 3/8"=1'-0"

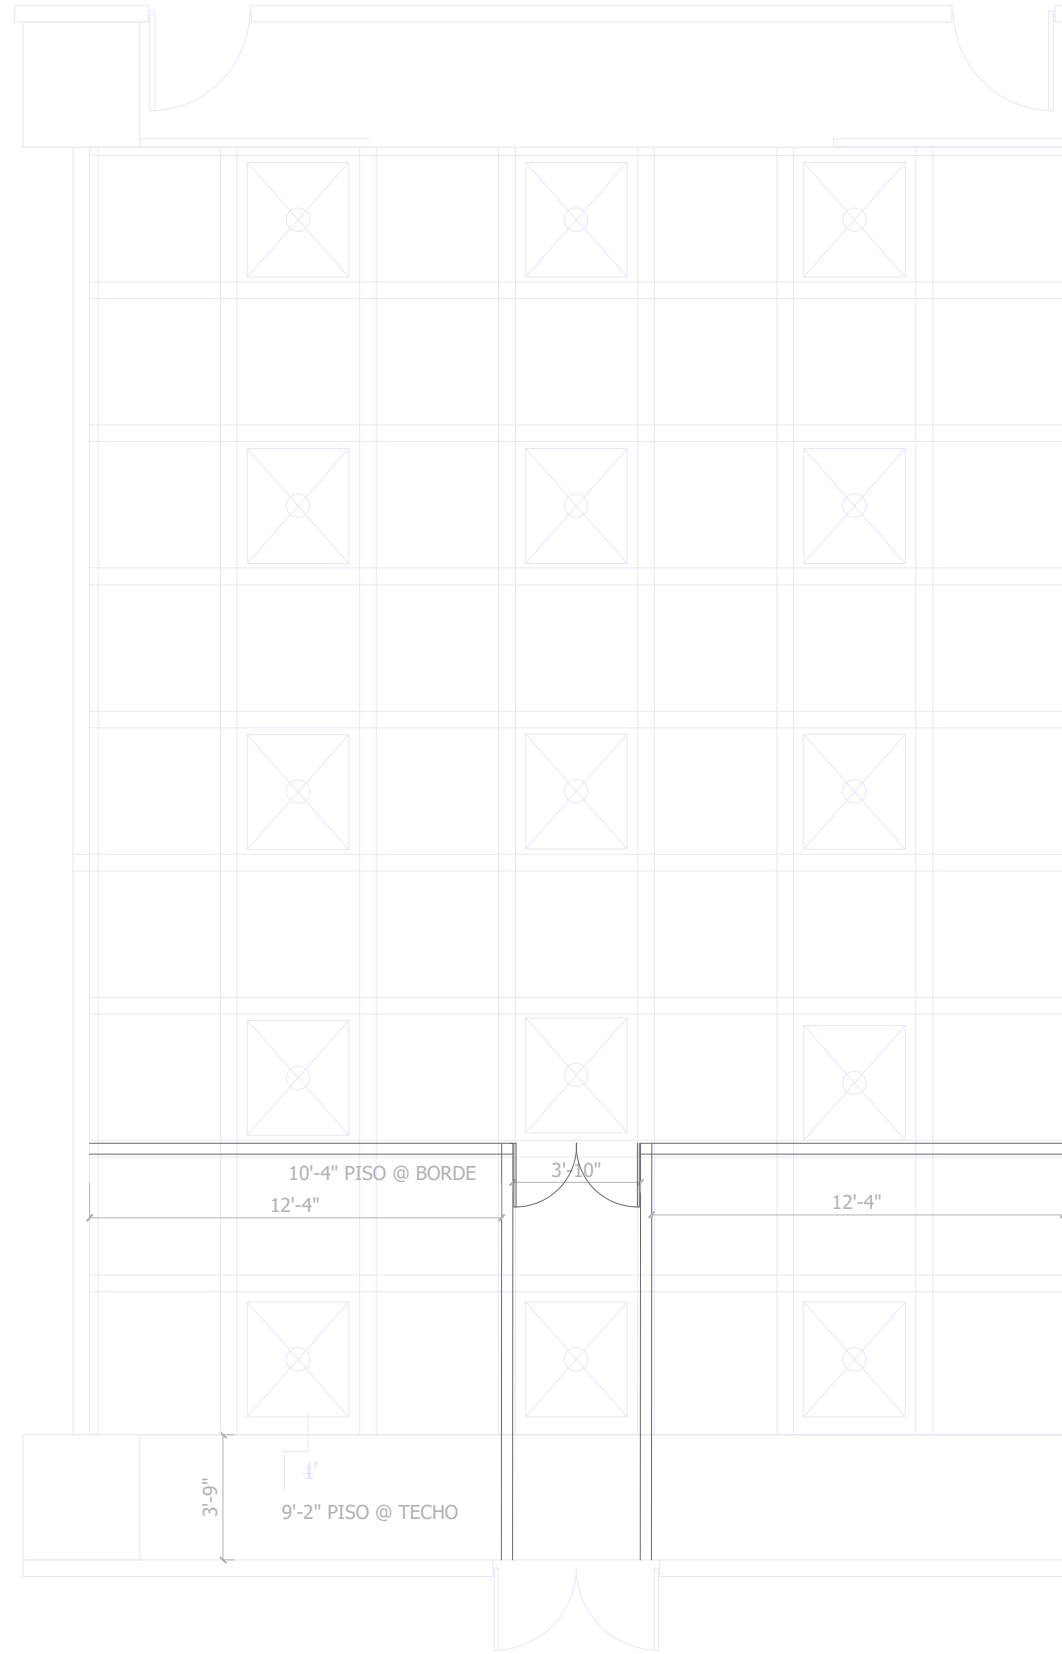

**PAREDES NUEVAS**  
 ESCALA: 3/8"=1'-0"

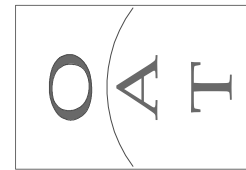

R E V I S I O N S		
NO.	DESCRIPTION	DATE

**TRIBUNAL GENERAL DE JUSTICIA**  
**OFICINA DE ADMINISTRACION DE LOS TRIBUNALES**  
**DIRECTORIA DE ADMINISTRACION**  
**DIVISION DE LOCALES Y SERVICIOS ESPECIALES**

APPROVED BY: \_\_\_\_\_  
 APPROVED DATE: \_\_\_\_\_

PROJECT NAME: AREA PARA PUBLICO DE SALUD MENTAL – SALA 506  
 PROJECT LOCATION: CENTRO JUDICIAL DE BAYAMON, BAYAMON  
 DRAWING DESCRIPTIONS: PAREDES NUEVAS

ESPEC: EN ADMINISTRACION  
 CHECKED BY: ING DANIEL PADILLA  
 DRAWING BY: PETER RUBI  
 SHEET NO. A-1  
 PROJECT DATE: SEPTIEMBRE 2023  
 DRAWING DATE:  
 PRINTING DATE:  
 DRAWING SCALE: 3/8"=1'-0"